


PLOT DATE: 8/7/2019 3:22:23 PM
TEMPLATE VERSION: 2.8.20141012



MAP KEY

Shelter Locations

- Primary
- Secondary

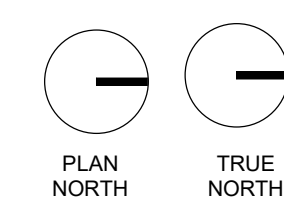


01 LEVEL 1 FLOOR PLAN - DPS
1/8" = 1'-0"

© 2018 HKS, INC.



SHEET NO.

PLOT DATE: 8/27/2019 3:22:32 PM TEMPLATE VERSION: 218.52/14102

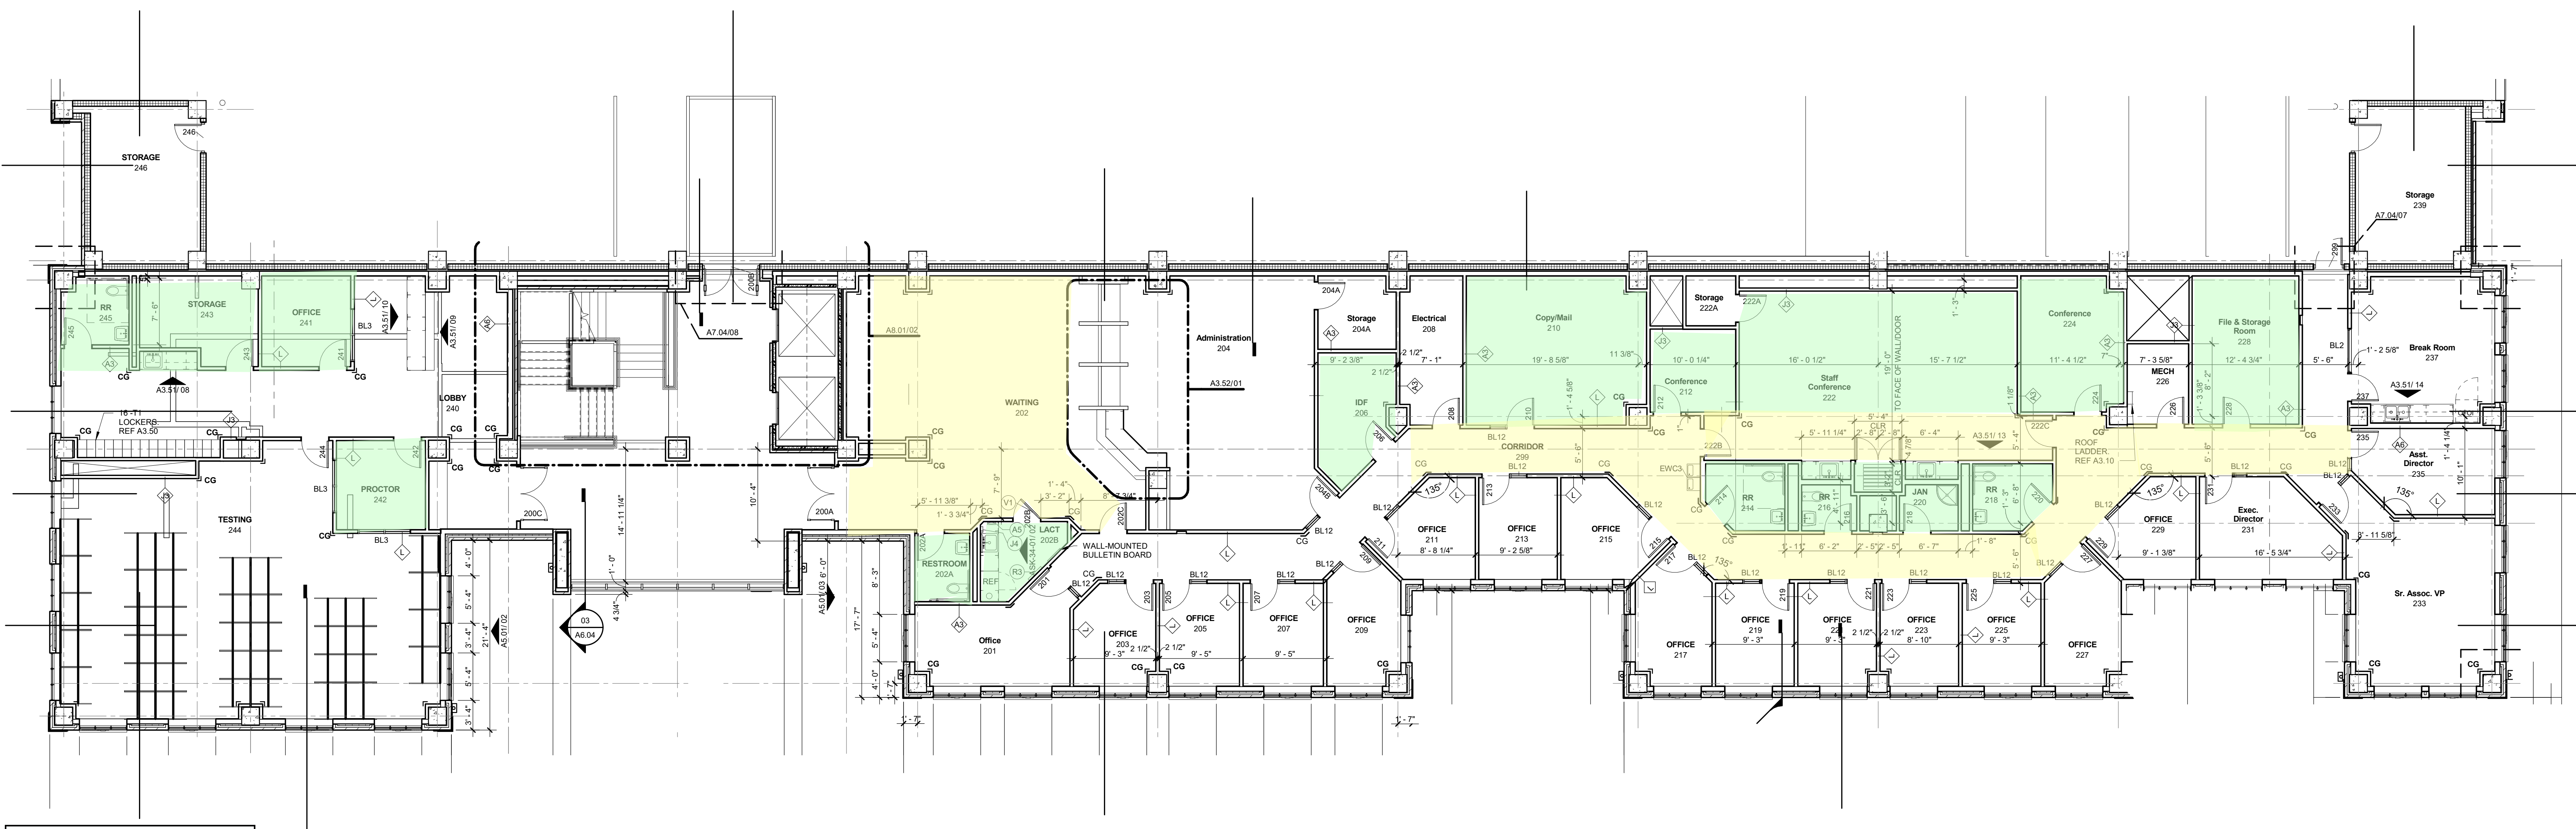

MAP KEY

Shelter Locations

Primary

Secondary

PLAN NORTH

TRUE NORTH

02

LEVEL 2 FLOOR PLAN

1/8" = 1'-0"

WALL TYPE DESIGNATIONS ADDED

THE RECORD DRAWING REVISIONS CONTAINED HEREIN ARE BASED SOLELY UPON INFORMATION PROVIDED BY THE CONTRACTOR. NO REPRESENTATION IS MADE BY HKS, INC. OR ITS CONSULTANTS REGARDING THE ACCURACY OF THE INFORMATION SUPPLIED.

TEXAS WOMAN'S UNIVERSITY DENTON

WEST PARKING GARAGE DENTON CAMPUS

DE-15-116-DT-024

